

Phase 1 Portion of Building

- 2,709 full bays.
- 4FT wide x 8'-3" lg. std. bays.

Phase 2 Portion of Building

- 2,083 full bays.
- 8 half bay (down spout areas)
- 4FT wide x 8'-3" lg. std. bays.
- 240 End Uprights.
- 1,915 Intermediate Uprights.
- 6'-0" Typ. Int. Aisle Clearance.
- (22) Flue Spaces @ 24" wide.
- (6) Flue Spaces @ 12" wide.
- (1) Flue Space @ 18" wide.
- (1) Flue Space @ 21" wide.

B	10/24/16	JCB	AS BUILT.	JCB
A	5/24/16	JCB	INITIAL RELEASE TO CUSTOMER FOR R.U.R.	JCB
REV.	DATE	BY	DESCRIPTION	APRV

**Conveyor Specialties, Inc.**  
841 Brian Dr.  
Crest Hill, IL 60403-2483

Phone: 815-727-7638 Fax: 815-727-7636 [www.conveyorspecialtiesinc.com](http://www.conveyorspecialtiesinc.com)


This drawing and all information contained herein is the property of Conveyor Specialties, Inc.  
Do not use or copy without permission. Drawing is subject to return upon demand.

TITLE: Standard Rack Layout.  
Remainder of Building - Phase 2.  
Preliminary Layout Drawing.


SITE LOCATION: W.W. Grainger  
3501 Corporate Drive  
Joliet, IL 60435

CUSTOMER:	W.W. Grainger	LOCATION:	Joliet, IL
SCALE:	N.T.S.	DATE:	5/24/16
FILE NAME:	\\Quotes\W.W. Grainger\16-125 Additional Rack in Joliet\16-125-L100.dwg		
DRAWING NUMBER:	16-125-L100	REVISION:	B
SHEET: 1 of 3			


Latest GRAINGER  
beam height  
locations. From  
email dated  
5/19/2016.

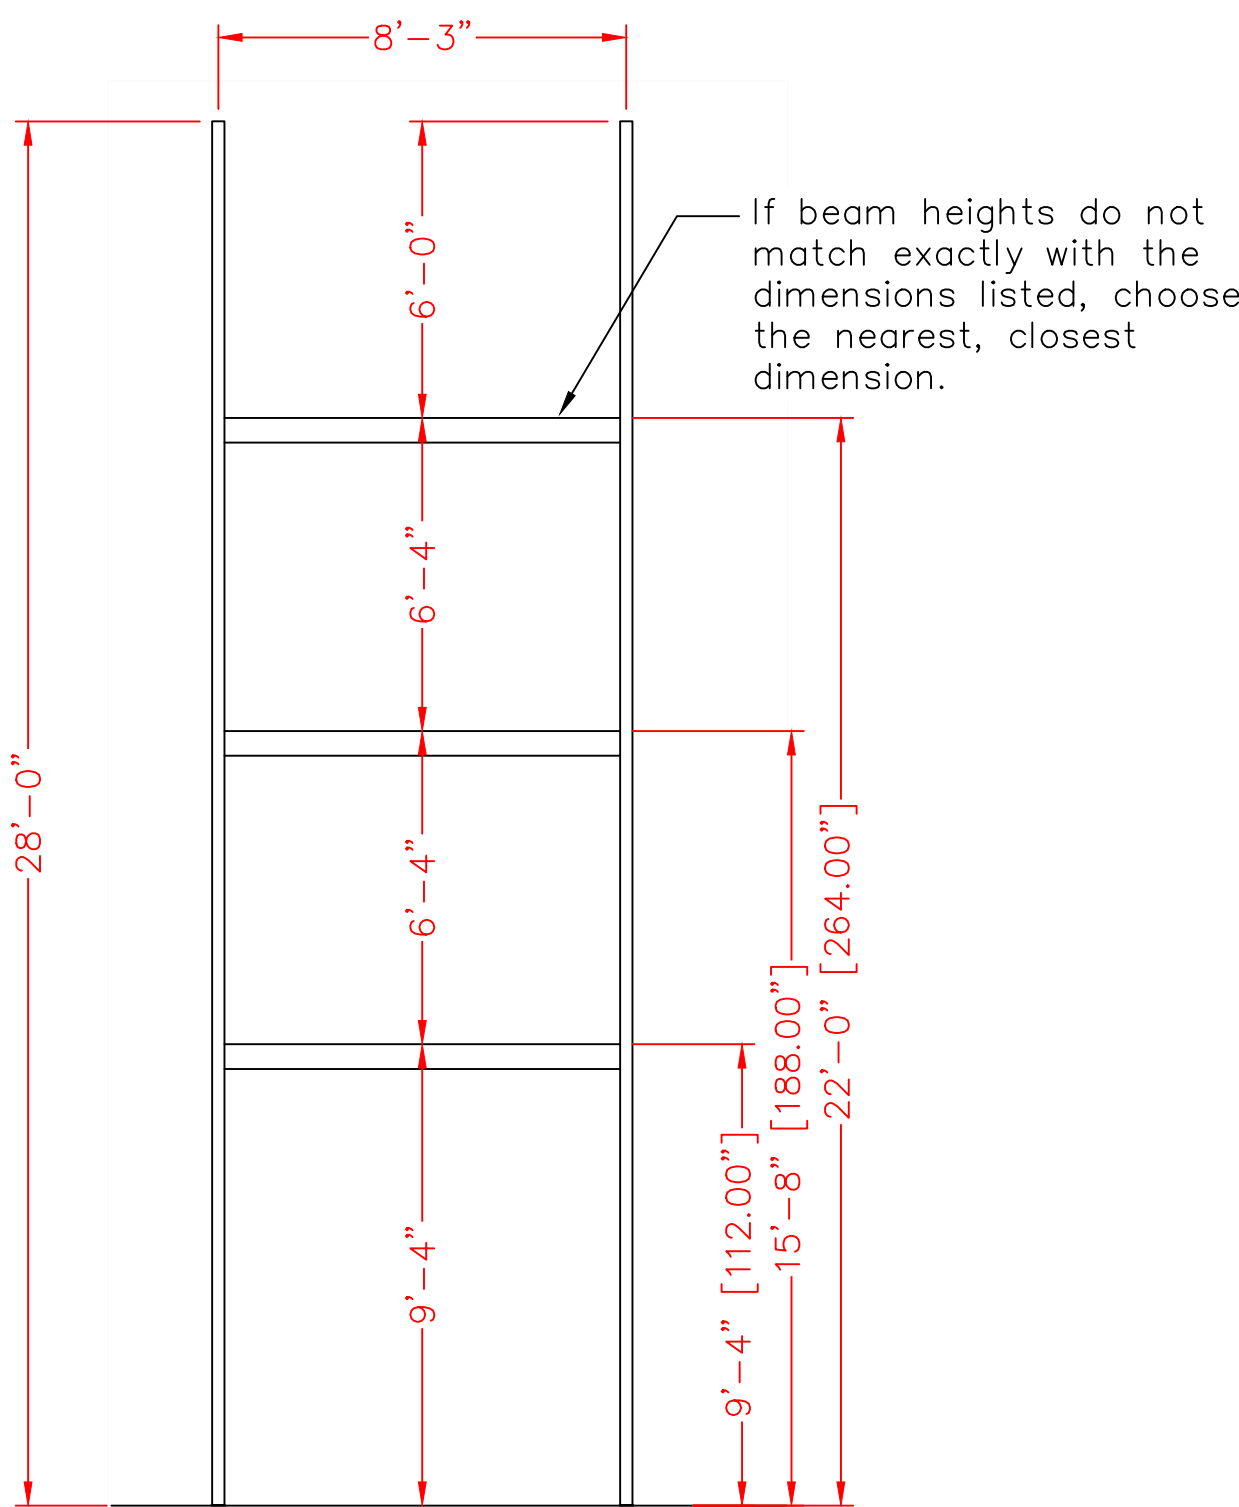

Typical Elevation View  
1/4" = 1'-0"

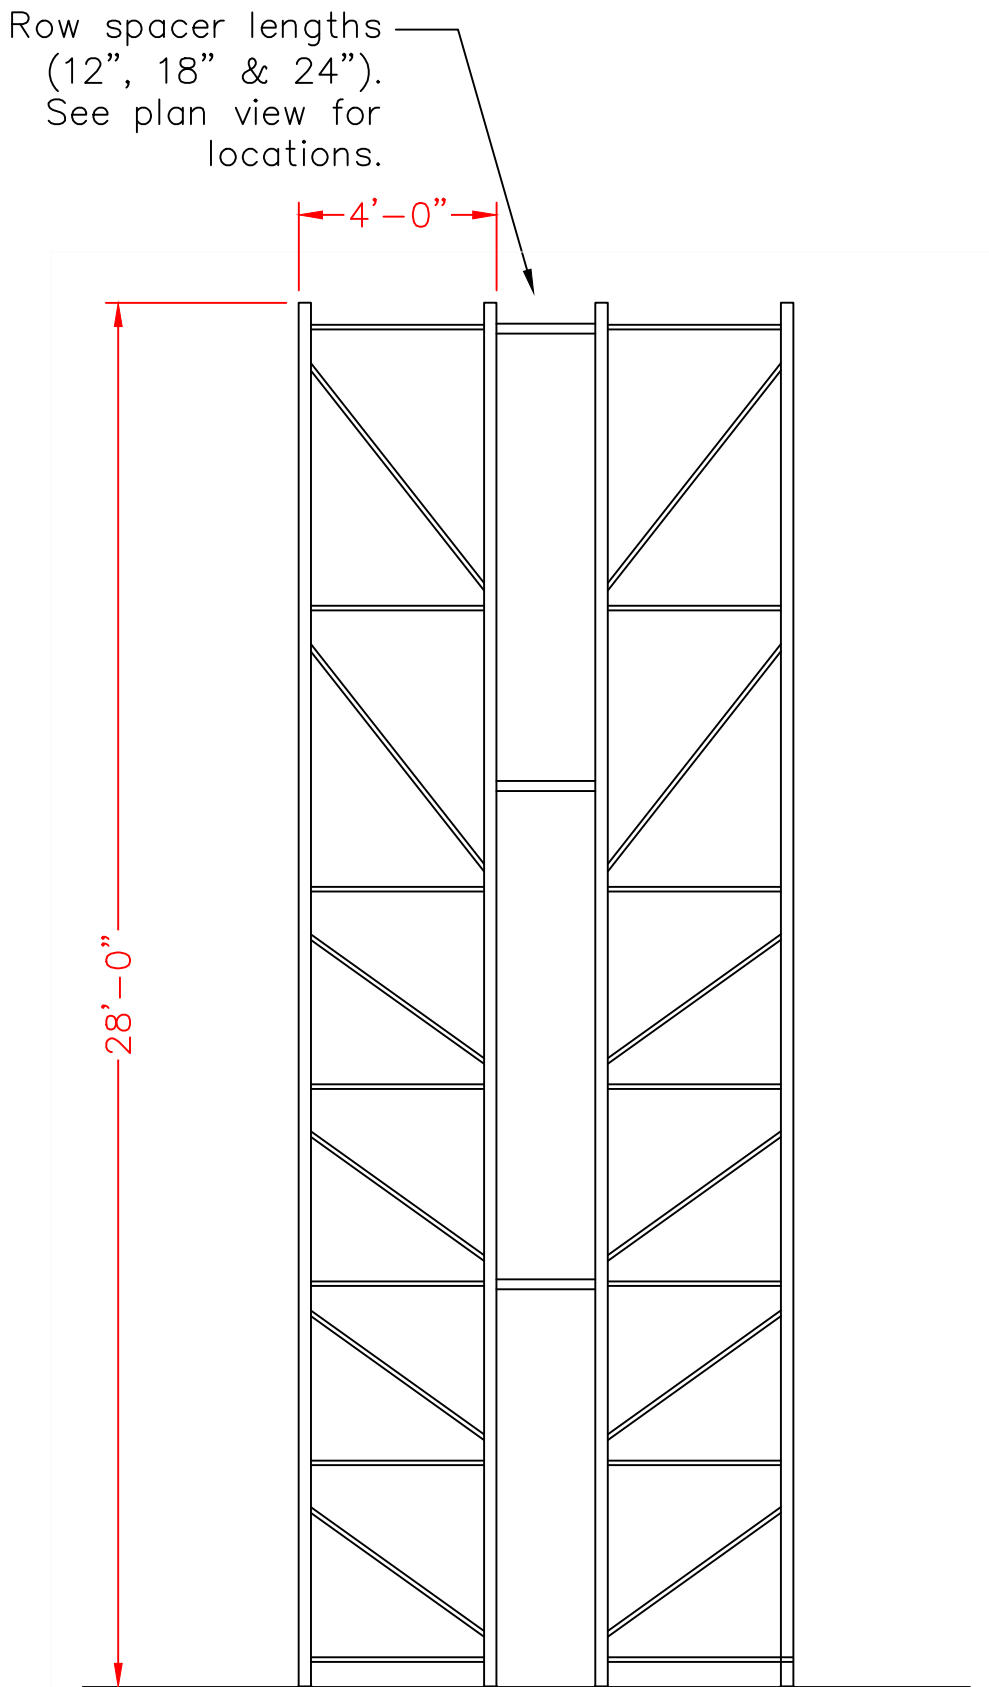

Intermediate Upright  
Elevation View  
1/4" = 1'-0"

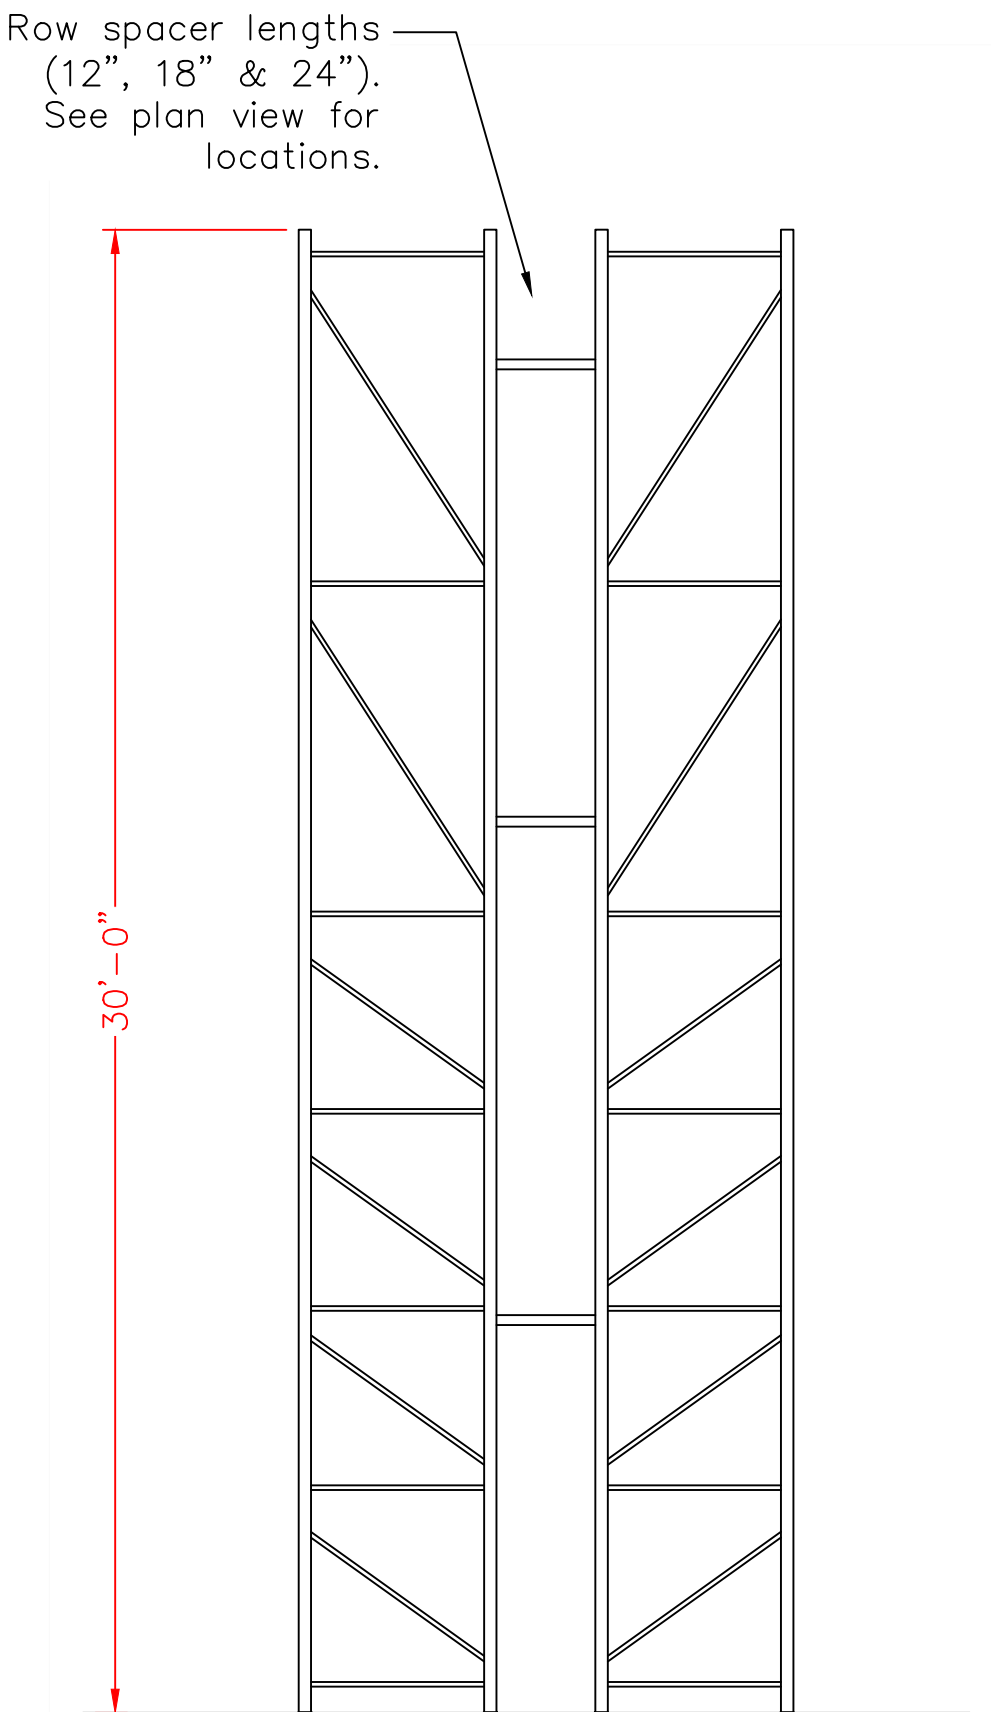

End-of-Row Upright  
Elevation View  
1/4" = 1'-0"  
(2) Req'd at each  
end

A	5/24/16	JCB	INITIAL RELEASE TO CUSTOMER FOR R.U.R.	JCB
REV.	DATE	BY	DESCRIPTION	APRV

**Conveyor Specialties, Inc.**  
841 Brian Dr.  
Crest Hill, IL 60403-2483  
Phone: 815-727-7638 Fax: 815-727-7636 www.conveyorspecialtiesinc.com

This drawing and all information contained herein is the property of Conveyor Specialties, Inc.  
Do not use or copy without permission. Drawing is subject to return upon demand.

TITLE: Standard Rack Layout.  
Elevation Views – Phase 2.  
Preliminary Layout Drawing.

SITE LOCATION: W.W. Grainger  
3501 Corporate Drive  
Joliet, IL 60435

CUSTOMER: W.W. Grainger  
SCALE: N.T.S.  
DATE: 5/24/16  
FILE NAME: I:\Quotes\W.W. Grainger\16-125 Additional Rack in Joliet\16-125-L100.dwg  
DRAWING NUMBER: 16-125-L100

LOCATION: Joliet, IL  
DRAWN BY: JCB  
APPROVED BY: JCB  
REVISION: B

SHEET: 2 of 2